
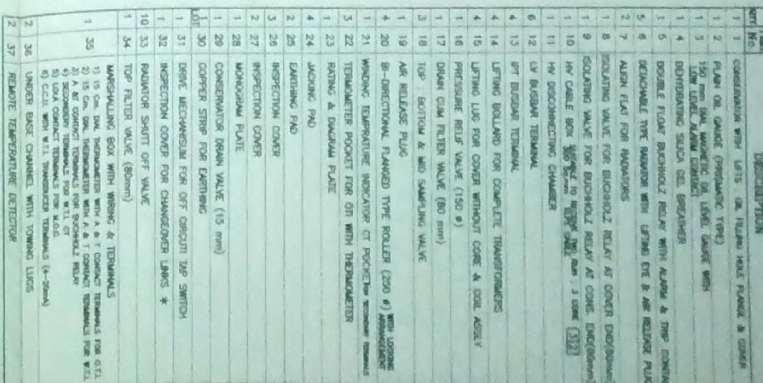
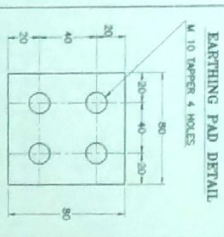


[illegible]

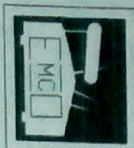

RECTIFIER TRANSFORMER

MADE IN INDIA BY

EMCO TRANSFORMERS LTD.

BOMBAY

SPECIFICATION
TYPE OF COOLING
RATING PRIMARY KVA
SECONDARY KVA
INSULATION LEVEL

IS:2026/1977, IS:4540
2 1
2 2
3 1
2 X 1876.8
HV: LI60 AC20LV: AC4

DIAGRAM DRG. NO.
MAKER'S SERIAL NO.
YEAR OF MANUFACTURE
FREQUENCY
No. OF PHASES PRIMARY
SECONDARY

2/11/0075/R-
50 HZ.
3
2X3

POSN	SWITCH	NO LOAD VOLTS	CURRENT (AMPS)	KVA	IMPEDANCE
	CONN. 1 2	HV	LV	HV	
1	-	187.68	-	2 X 1876.8 2654.2	
2	3-12 13-4	177.67	219.76	2 X 1776.4 2512.2	
3	3-12 13-5	167.66	207.38	2 X 1676.3 2370.65	
4	3-12 13-6	157.65	195.0	2 X 1576.2 2229.08	
5	3-12 13-7	147.64	182.5	2 X 1476.1 2087.52	
6	3-12 13-8	137.63	170.23	2 X 1376.0 1945.96	
7	3-12 13-9	127.62	157.86	2 X 1276.0 1804.54	
8	3-12 13-10	117.61	145.46	2 X 1175.0 1662.83	
9	3-12 13-11	107.60	133.08	2 X 1075.7 1521.27	
10	3-12 13-12	97.59	120.706	2 X 975.7 1379.85	
11	3-4 13-5	87.58	108.35	2 X 875.8 1238.57	
12	3-4 13-6	77.57	95.963	2 X 775.7 1097.00	
13	3-4 13-7	67.56	83.58	2 X 675.6 955.44	
14	3-4 13-8	57.55	71.20	2 X 575.5 813.88	
15	3-4 13-9	47.55	58.825	2 X 475.5 672.46	
16	3-4 13-10	37.54	46.44	2 X 375.4 530.90	
17	3-4 13-11	27.53	34.057	2 X 275.3 389.33	
18	3-4 13-12	17.52	21.674	2 X 175.2 247.77	

INTERPHASE TRANSFORMER
FREQUENCY HZ 150
VOLTS 2 X 56.81
CORE AND WINDING MASS KG 9200
GUARANTEED MAXIMUM TEMPERATURE RISE IN OIL
GUARANTEED MAXIMUM TEMPERATURE RISE IN WINDING
TEMPERATURE OF WATER AT INLET
CUSTOMER'S REFERENCE P.O NO. C-63122514 DTD 23/11/96
CUSTOMER M/S ABB A/C SWIL

CURRENT QUANTITY OF OIL LIT 2 X 10 KA 1 3
MASS OF OIL KG 5785
TOTAL MASS KG 21800
C 50
C 55
C 57

2/11/0075/R-

Revision Details		
Rev No	Sl No	EL's Comments
1	1	Description in the title block changed to "Rating Plate 20KA, 100V System" from "Rating plate".
1	2	Switch connection details for tap positions 2-16 revised
1	3	ABB's Comments: Interphase transformer current changed to 2x10KA from 2x20KA
2	1	Type of cooling changed to ONAN from OFWF
2	2	Rating of primary KVA changed to 2644 from 2654.2
		Other clarification sought by EL on revision "Q" are given in ABB's letter No. IAD2WB6104-006 dt. 970527
3	1	Rating of primary KVA changed to 2654.2 from 2644

- NOTES :
- 1) ALL DIMENSIONS ARE IN mm EXCEPT OTHERWISE STATED.
 - 2) THICKNESS OF THE RATING PLATE SHALL BE 20 SWG.
 - 3) SIZE OF THE RATING PLATE SHALL BE 305 X 255 mm
 - 4) MATERIAL OF THE DIAGRAM PLATE SHALL BE STAINLESS STEEL.
 - 5) THE PLATE IS REQUIRED TO BE USED FOR OUTDOOR DUTY.

CUSTOMER : ABB A/C SWIL
CONSULTANTS : EIL
CUSTOMER'S REF : P.O NO. C-63122514 DTD. 23/11/96

REV. 3. 16/12/97	REV 2 : 31/08/97	W.O.	UT098/B
AS BUILT	TYPE OF COOLING CHANGE TO ONAN FROM OFWF	DRN PRD	VLK
		CHD APPD	VSP
DATE	23/09/96	SCALE - NTS	
		MAIL -	
RATING PLATE 20 KA, 100V SYSTEM 1 1		EMCO TRANSFORMERS LTD. MUMBAI	
DRG. No. 2/11/0075/R3			